


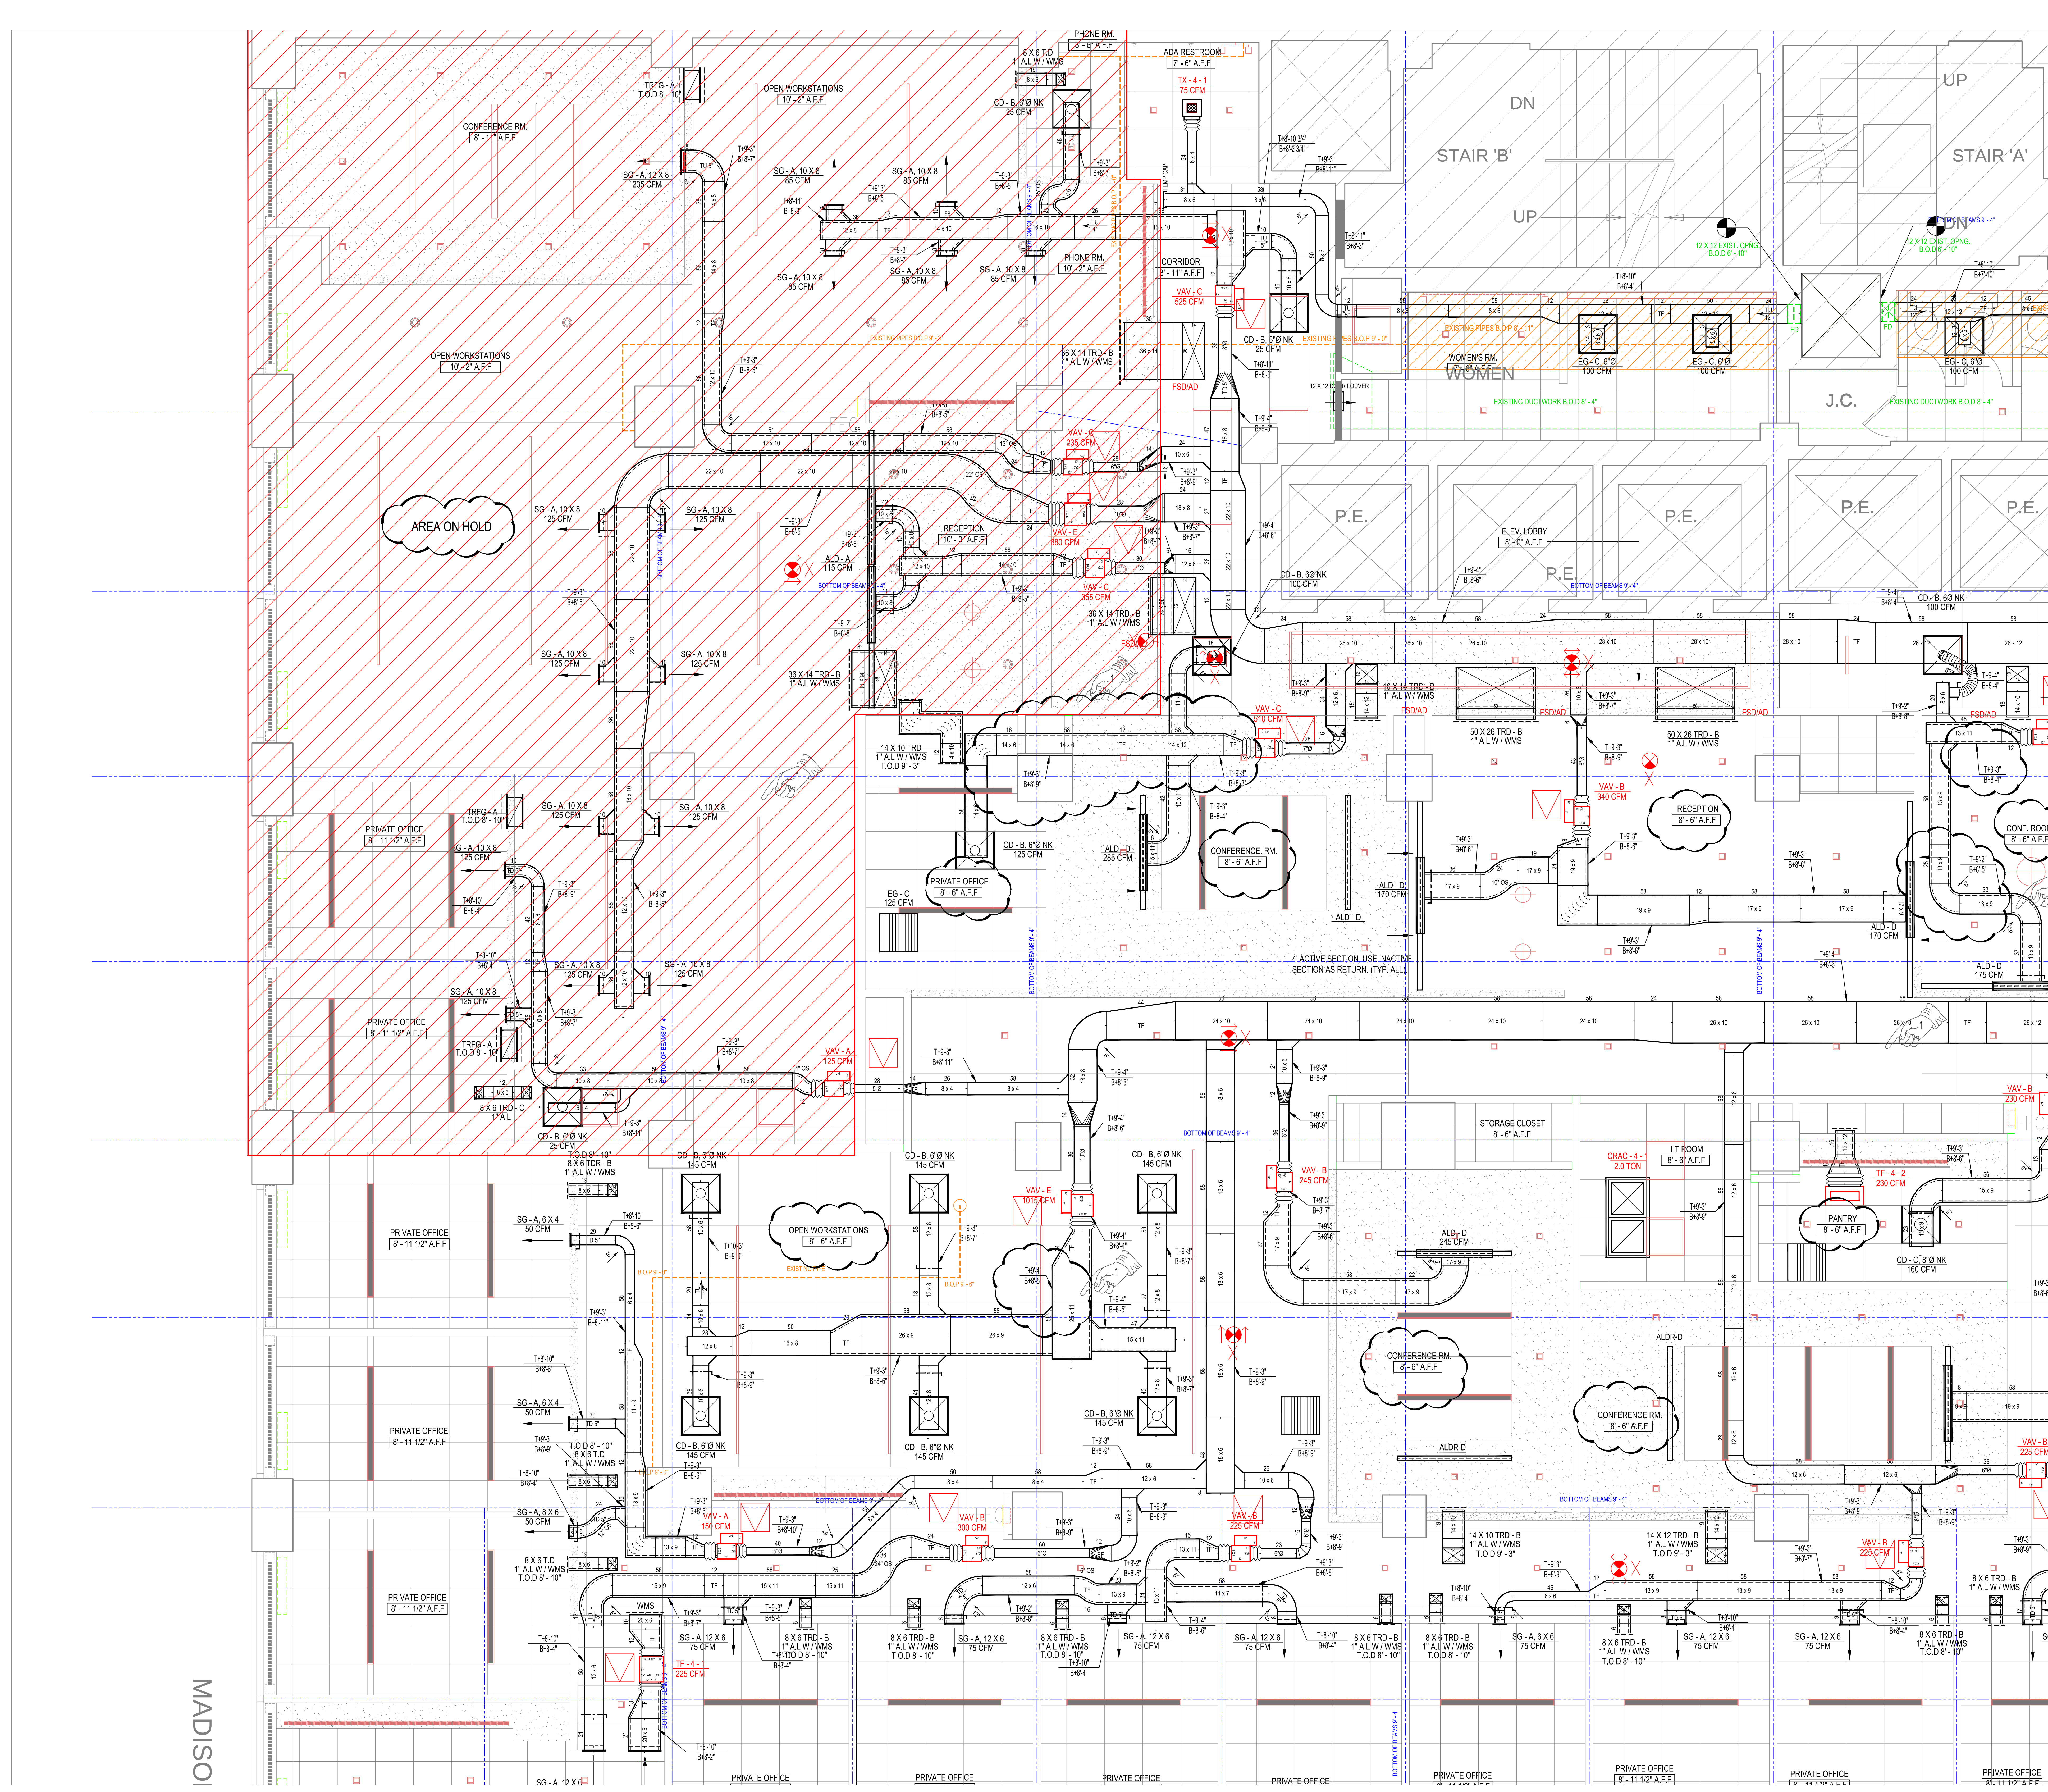

MADISON

ARCH | ENGR | GC NOTES

1. CONFLICTS BETWEEN CEILING HEIGHTS AND DUCTWORK THROUGHOUT THE SPACE.

ARCHITECTS NOTE FROM APPROVED AS NOTED DRAWING DATED 07-08-20 INDICATES CEILING HEIGHT WOULD BE DICTATED BY DUCT ELEVATIONS.

THIS SYMBOL INDICATES THE POINT OF CONNECTION WITH EXISTING LAYOUT.

THIS SYMBOL DESIGNATES A NOTE TO THE ARCHITECT OR ENGINEER. IF NOT ACTED UPON, CONCURRENCE WITH THAT WHICH IS INDICATED ON THIS DRAWING WILL BE ASSUMED.

COORDINATION SIGN OFF

COMPANY	TRADE	SIGNATURE	DATE

PLOT PLAN

FLOOR ELEVATION

REVISIONS

REV	DESCRIPTION	DATE	BY
2.	APPROVED AS NOTED	07-15-20	AG
1.	REVISE AND RESUBMIT	07-06-20	AG

ICONIC
MECHANICAL
SERVICES CORP.


64-70 MAURICE AVE. MASPETH, NY 11378 • 718-898-5500

JOB

477 MADISON AVENUE

TITLE	4TH FLOOR MECHANICAL SHEETMETAL
ENGR	CFS ENGINEERING, D.P.C
ARCH	36" X 48"
DATE	07-15-20
DRWN BY	ANDREW GIRALDO

SCALE	3/8" = 1'-0"
SHEET	1 OF 2
DWS #	MS - 100

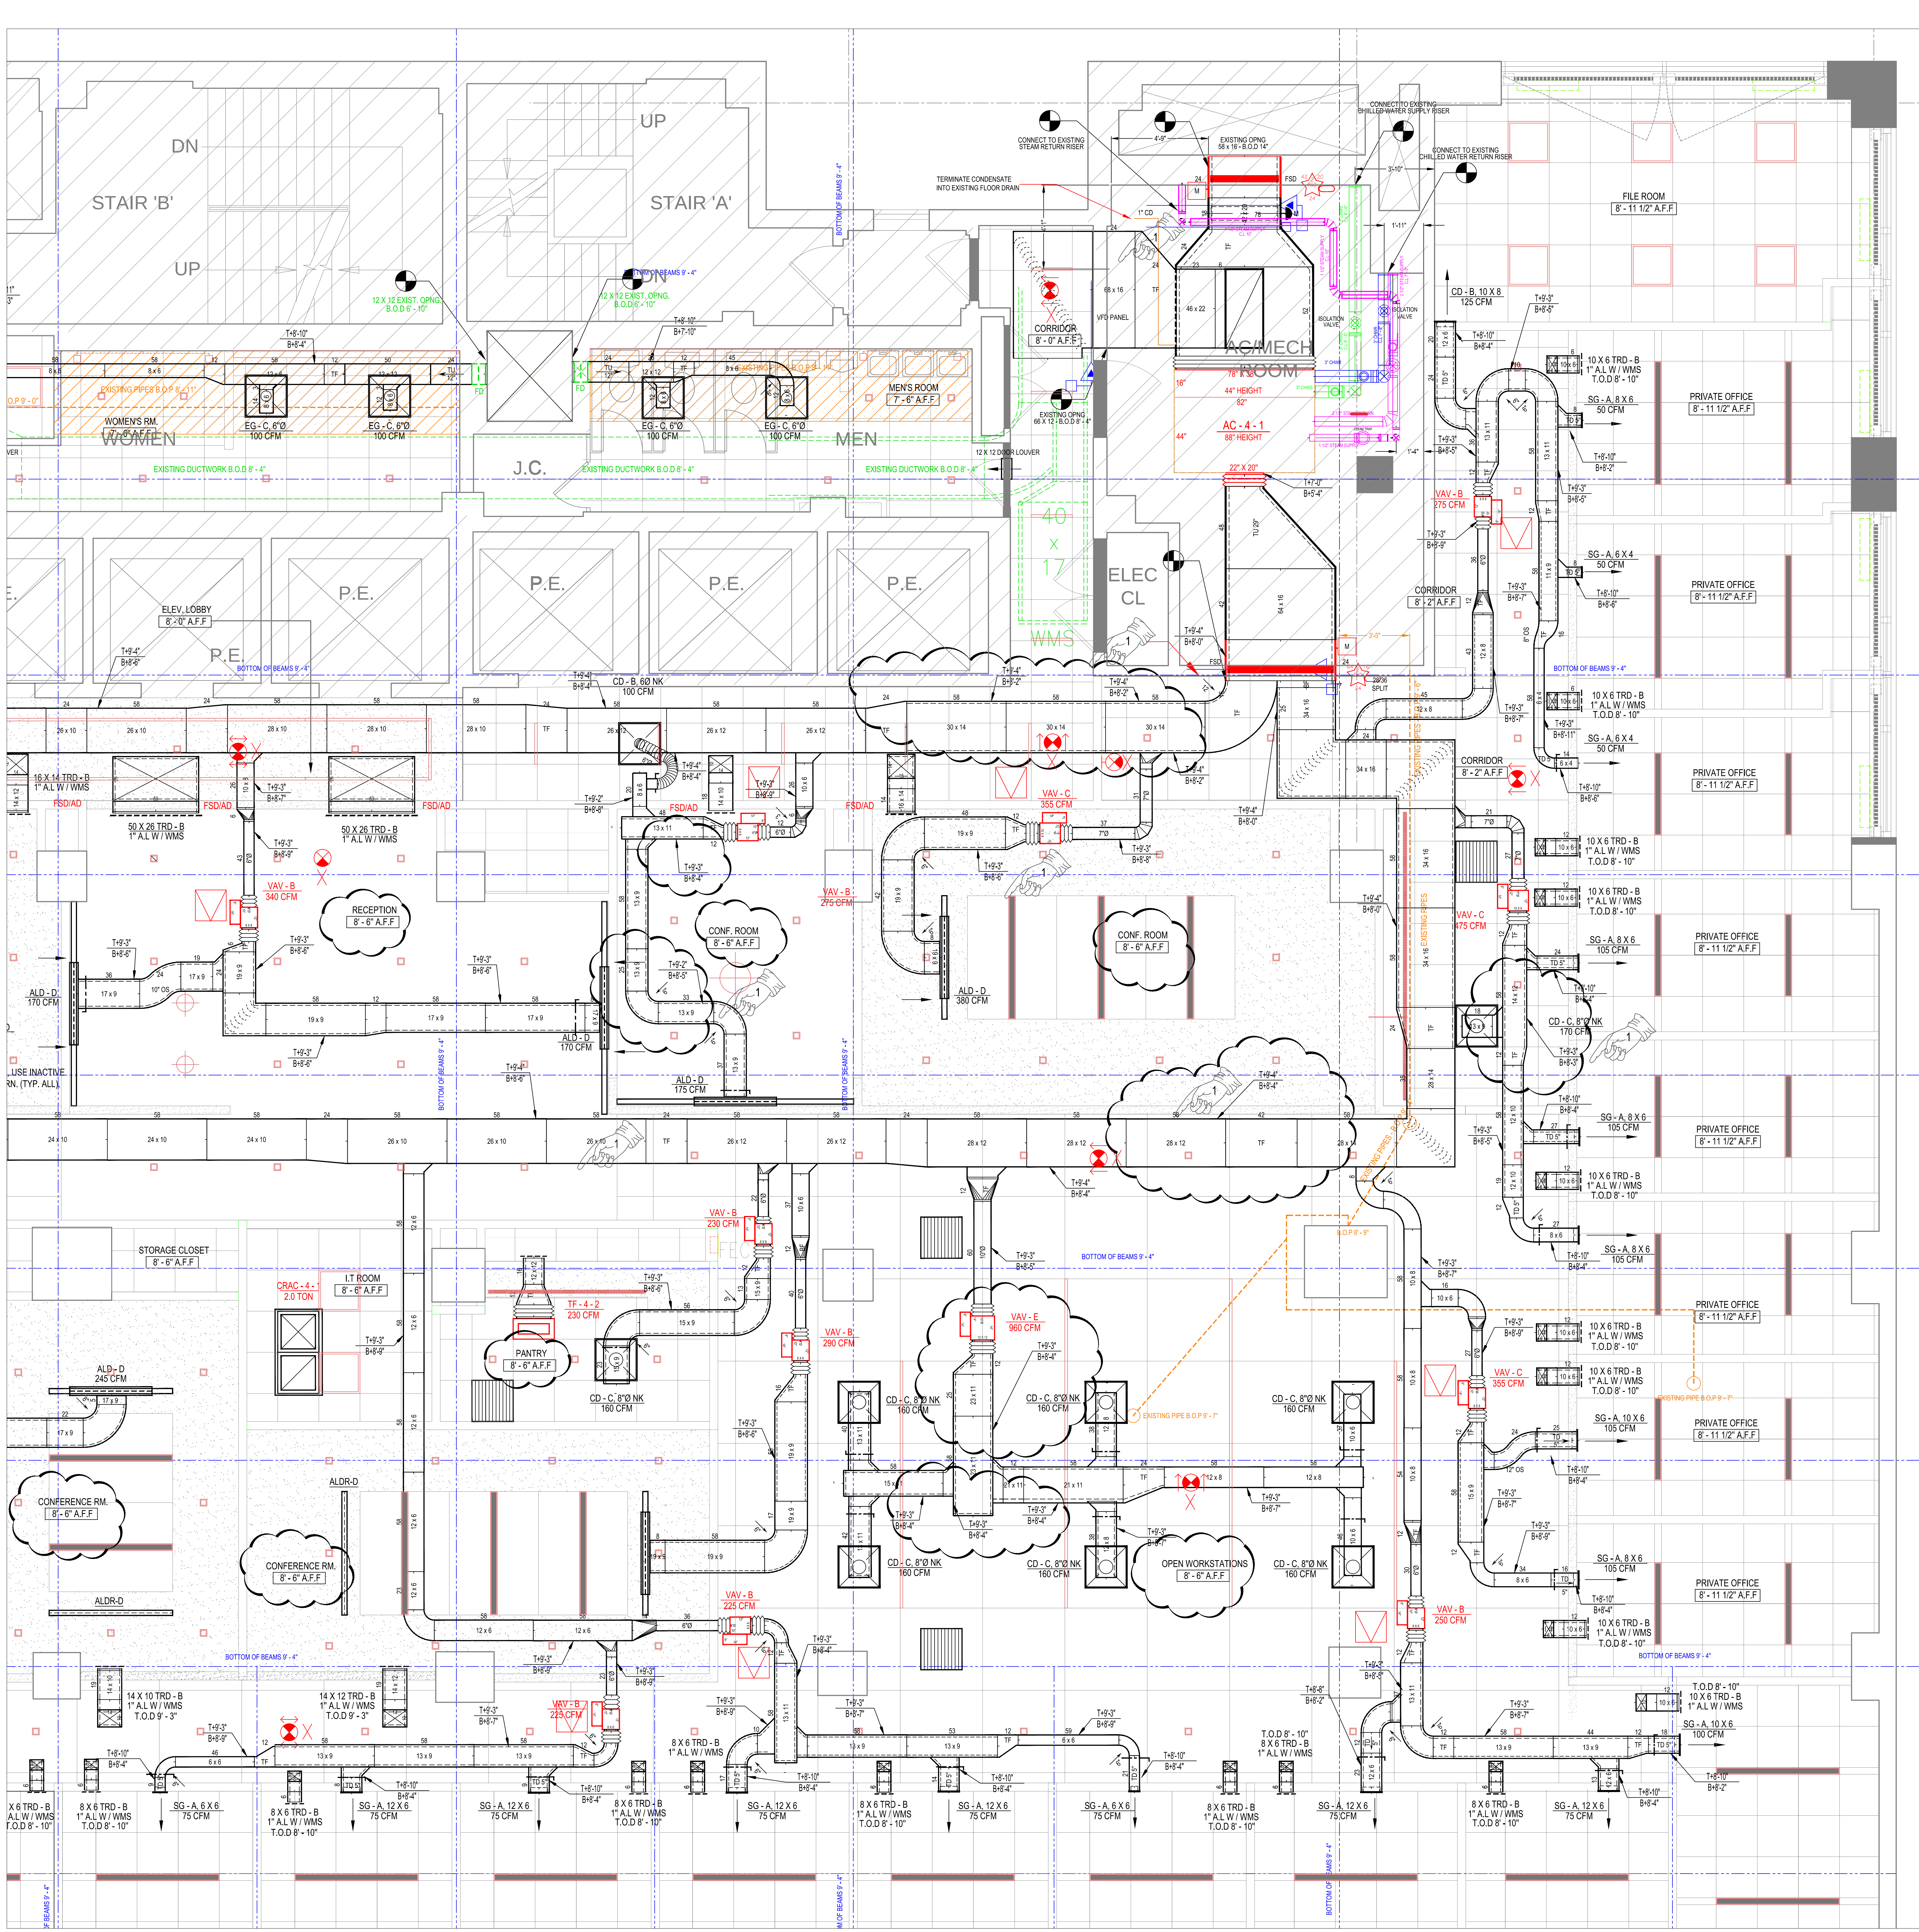

ARCH | ENGR | GC NOTES

1. CONFLICTS BETWEEN CEILING HEIGHTS AND DUCTWORK THROUGHOUT THE SPACE.

ARCHITECTS NOTE FROM APPROVED AS NOTED DRAWING DATED 07-08-20 INDICATES CEILING HEIGHT WOULD BE DICTATED BY DUCT ELEVATIONS.

THIS SYMBOL INDICATES THE POINT OF CONNECTION WITH EXISTING LAYOUT.

THIS SYMBOL DESIGNATES A NOTE TO THE ARCHITECT OR ENGINEER. IF NOT ACTED UPON, CONCURRENCE WITH THAT WHICH IS INDICATED ON THIS DRAWING WILL BE ASSUMED.

COORDINATION SIGN OFF

COMPANY	TRADE	SIGNATURE	DATE

PLOT PLAN

FLOOR ELEVATION

FL SLAB

10' - 4"

9' - 4"

FL SLAB

REVISIONS

REV	DESCRIPTION	DATE	BY
2.	APPROVED AS NOTED	07-15-20	AG
1.	REVISE AND RESUBMIT	07-06-20	AG

ICONIC

MECHANICAL SERVICES CORP.

64-70 MAURICE AVE. MASPEH, NY 11378 • 718-898-5500

JOB

477 MADISON AVENUE

TITLE

4TH FLOOR MECHANICAL SHEMETAL

ENGR

CFS ENGINEERING, D.P.C

ARCH

36" X 48"

DATE

07-15-20

PDF

36" X 48"

DATE

07-15-20

DRWN BY

ANDREW GIRALDO

SCALE

3/8" = 1'-0"

SHEET

2 OF 2

DWS #

MS - 100