


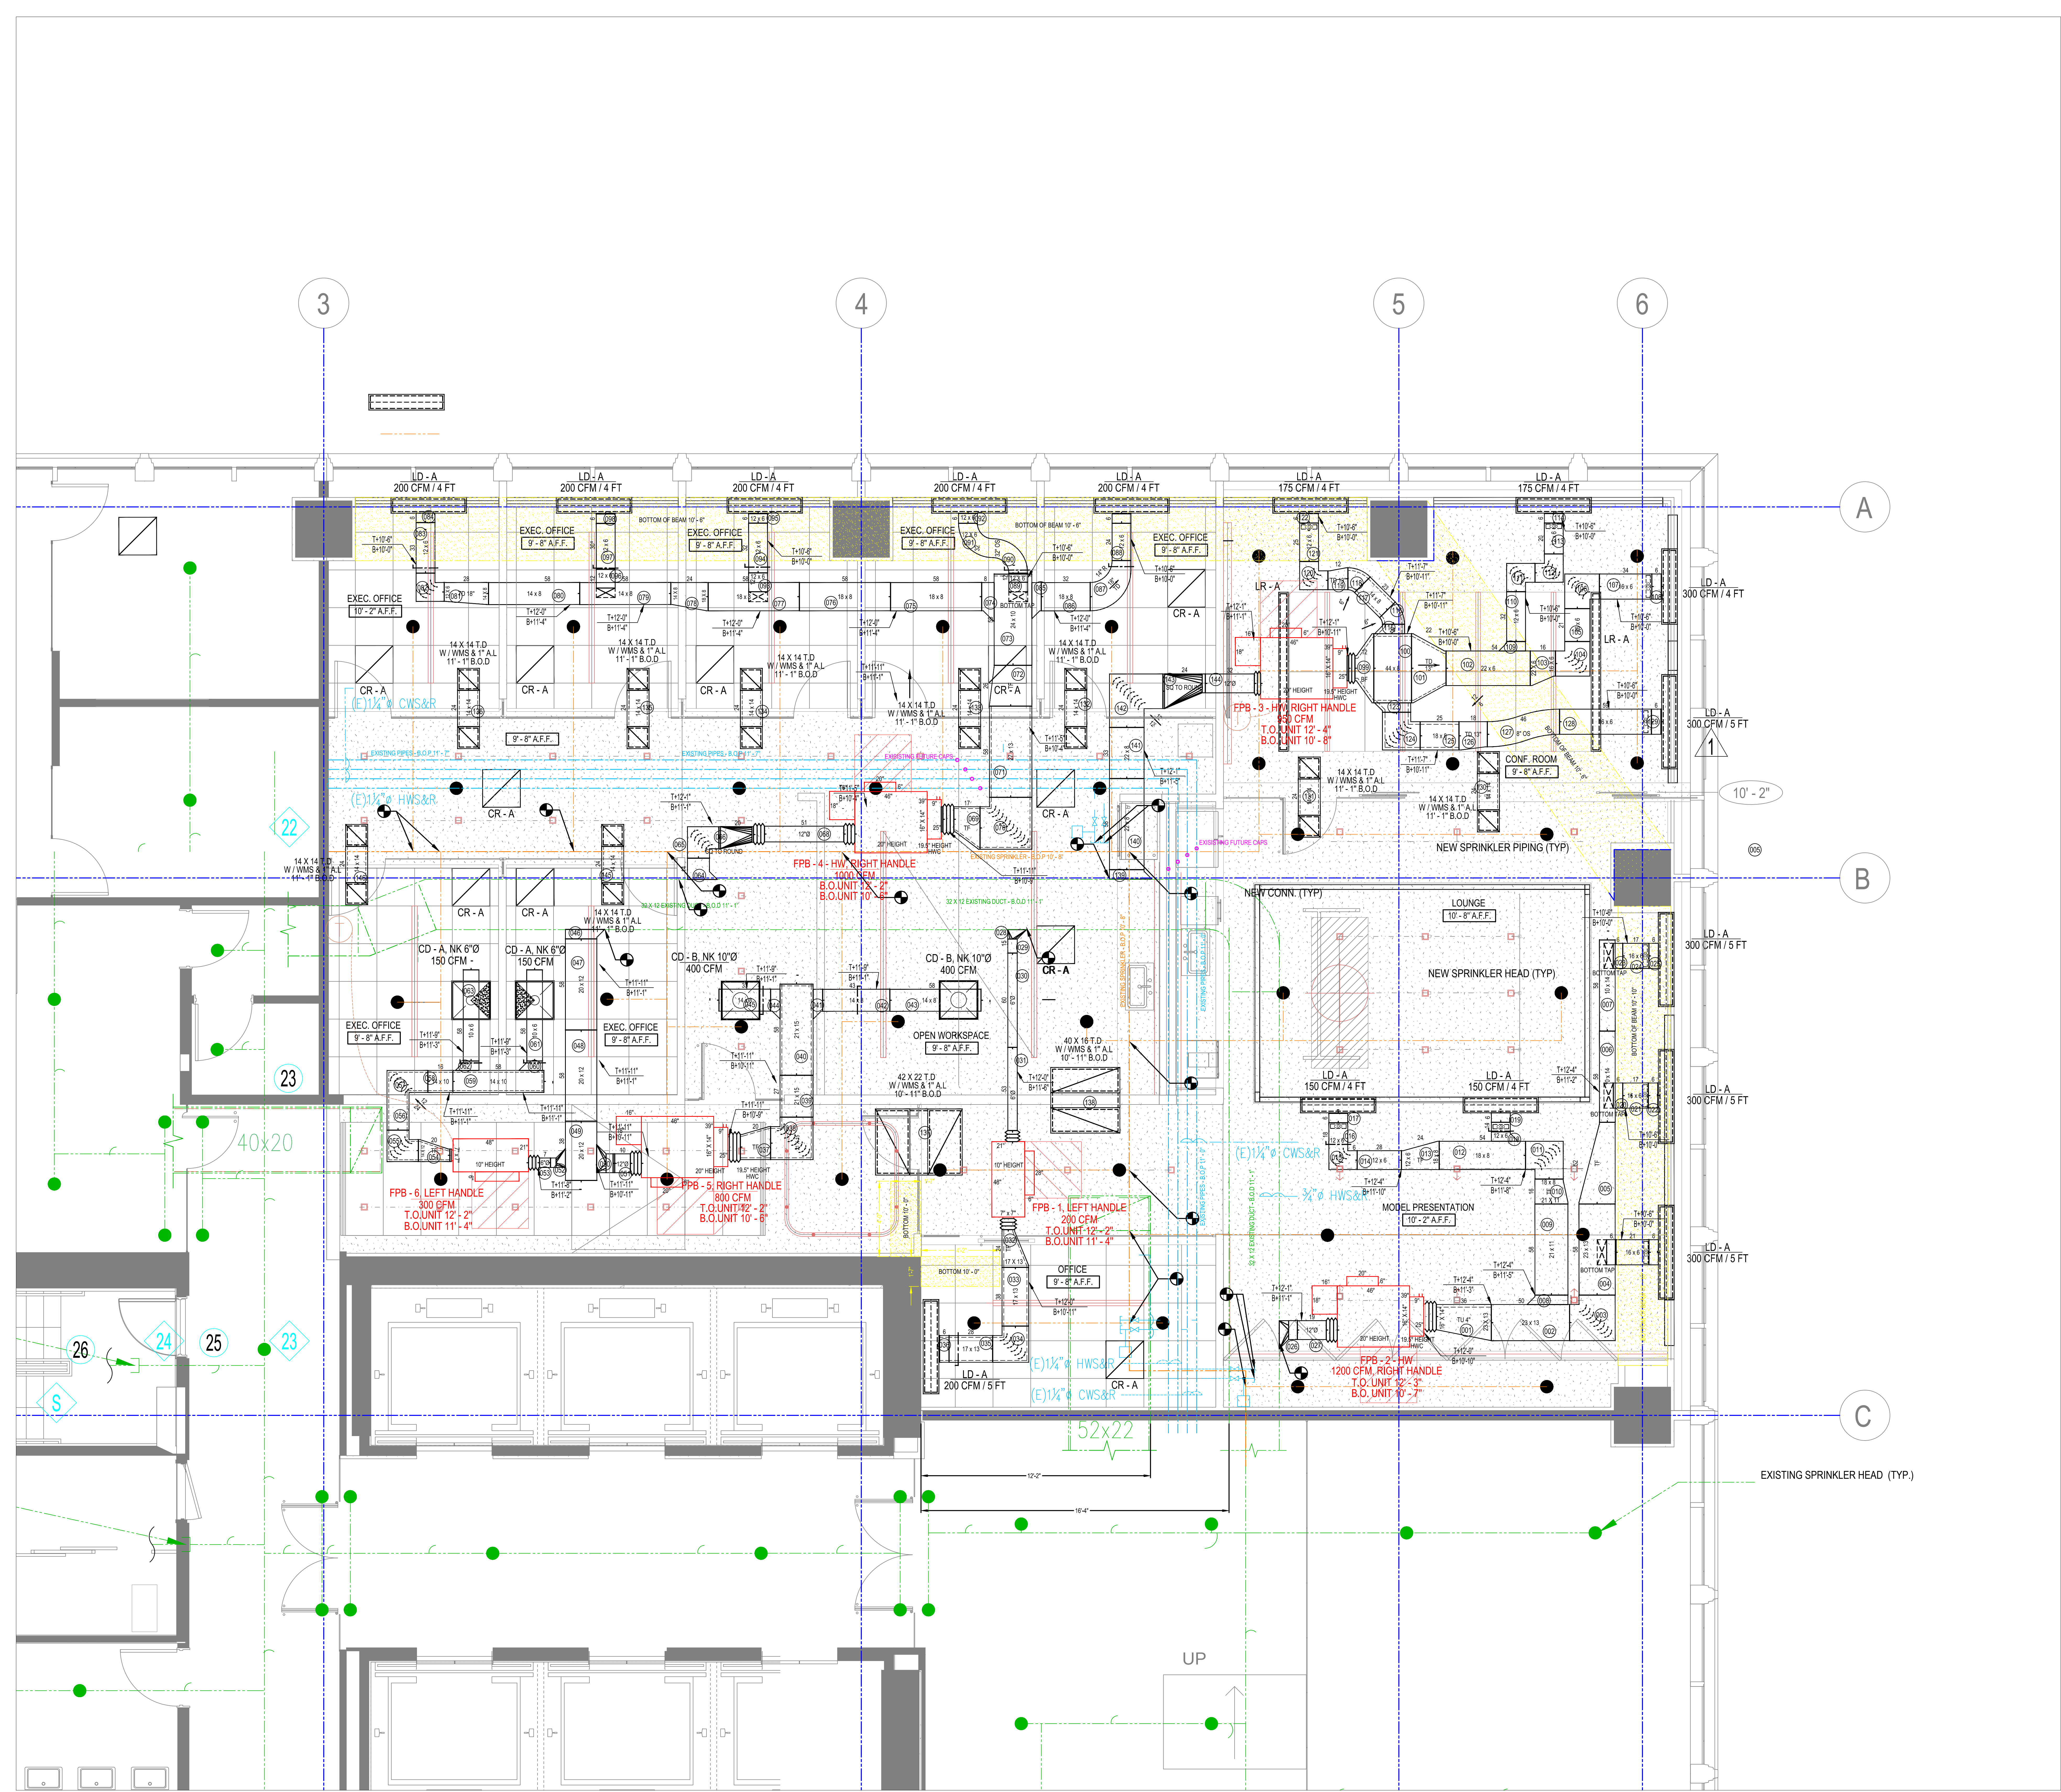

ARCH | ENGR | GC NOTES

1.

2.

3.

THIS SYMBOL INDICATES THE POINT OF CONNECTION WITH EXISTING LAYOUT.

THIS SYMBOL DESIGNATES A NOTE TO THE ARCHITECT OR ENGINEER, IF NOT ACTED UPON, CONCURRENCE WITH THAT WHICH IS INDICATED ON THIS DRAWING WILL BE ASSUMED.

COORDINATION SIGN OFF

COMPANY	TRADE	SIGNATURE	DATE

PLOT PLAN

FLOOR ELEVATION

REVISIONS

REV	DESCRIPTION	DATE	BY
2.	CORRECTIONS AS NOTED	03-23-20	A.G.
1.	REVISE AND RESUBMIT	02-24-20	A.G.

ICONIC
MECHANICAL SERVICES CORP.
64-70 MAURICE AVENUE
MASPETH, NY 11378

JOB

55 HUDSON
55 HUDSON YARDS
NEW YORK, NY 10001

TITLE	21ST FLR MECHANICAL SHEETMETAL		
ENGR	WSP MEP ENIGEEER		
ARCH	GENSLER		
PDF	36" X 48"	DATE	03-30-2020
DRWN BY	ANDREW GIRALDO		

SCALE	SHEET	1 OF 1	DWG #	MS - 222
3/8" = 1'-0"				